


FORMATION LEVEL	112.106	112.176	112.247	112.317	112.387	112.458	112.532	112.610	112.688	112.766
GROUND LEVEL	106.906	106.814	106.833	106.847	106.933	106.593	106.250	106.065	106.238	106.258
CHAINAGE	1140.000	1160.000	1180.000	1200.000	1220.000	1240.000	1260.000	1280.000	1300.000	1320.000

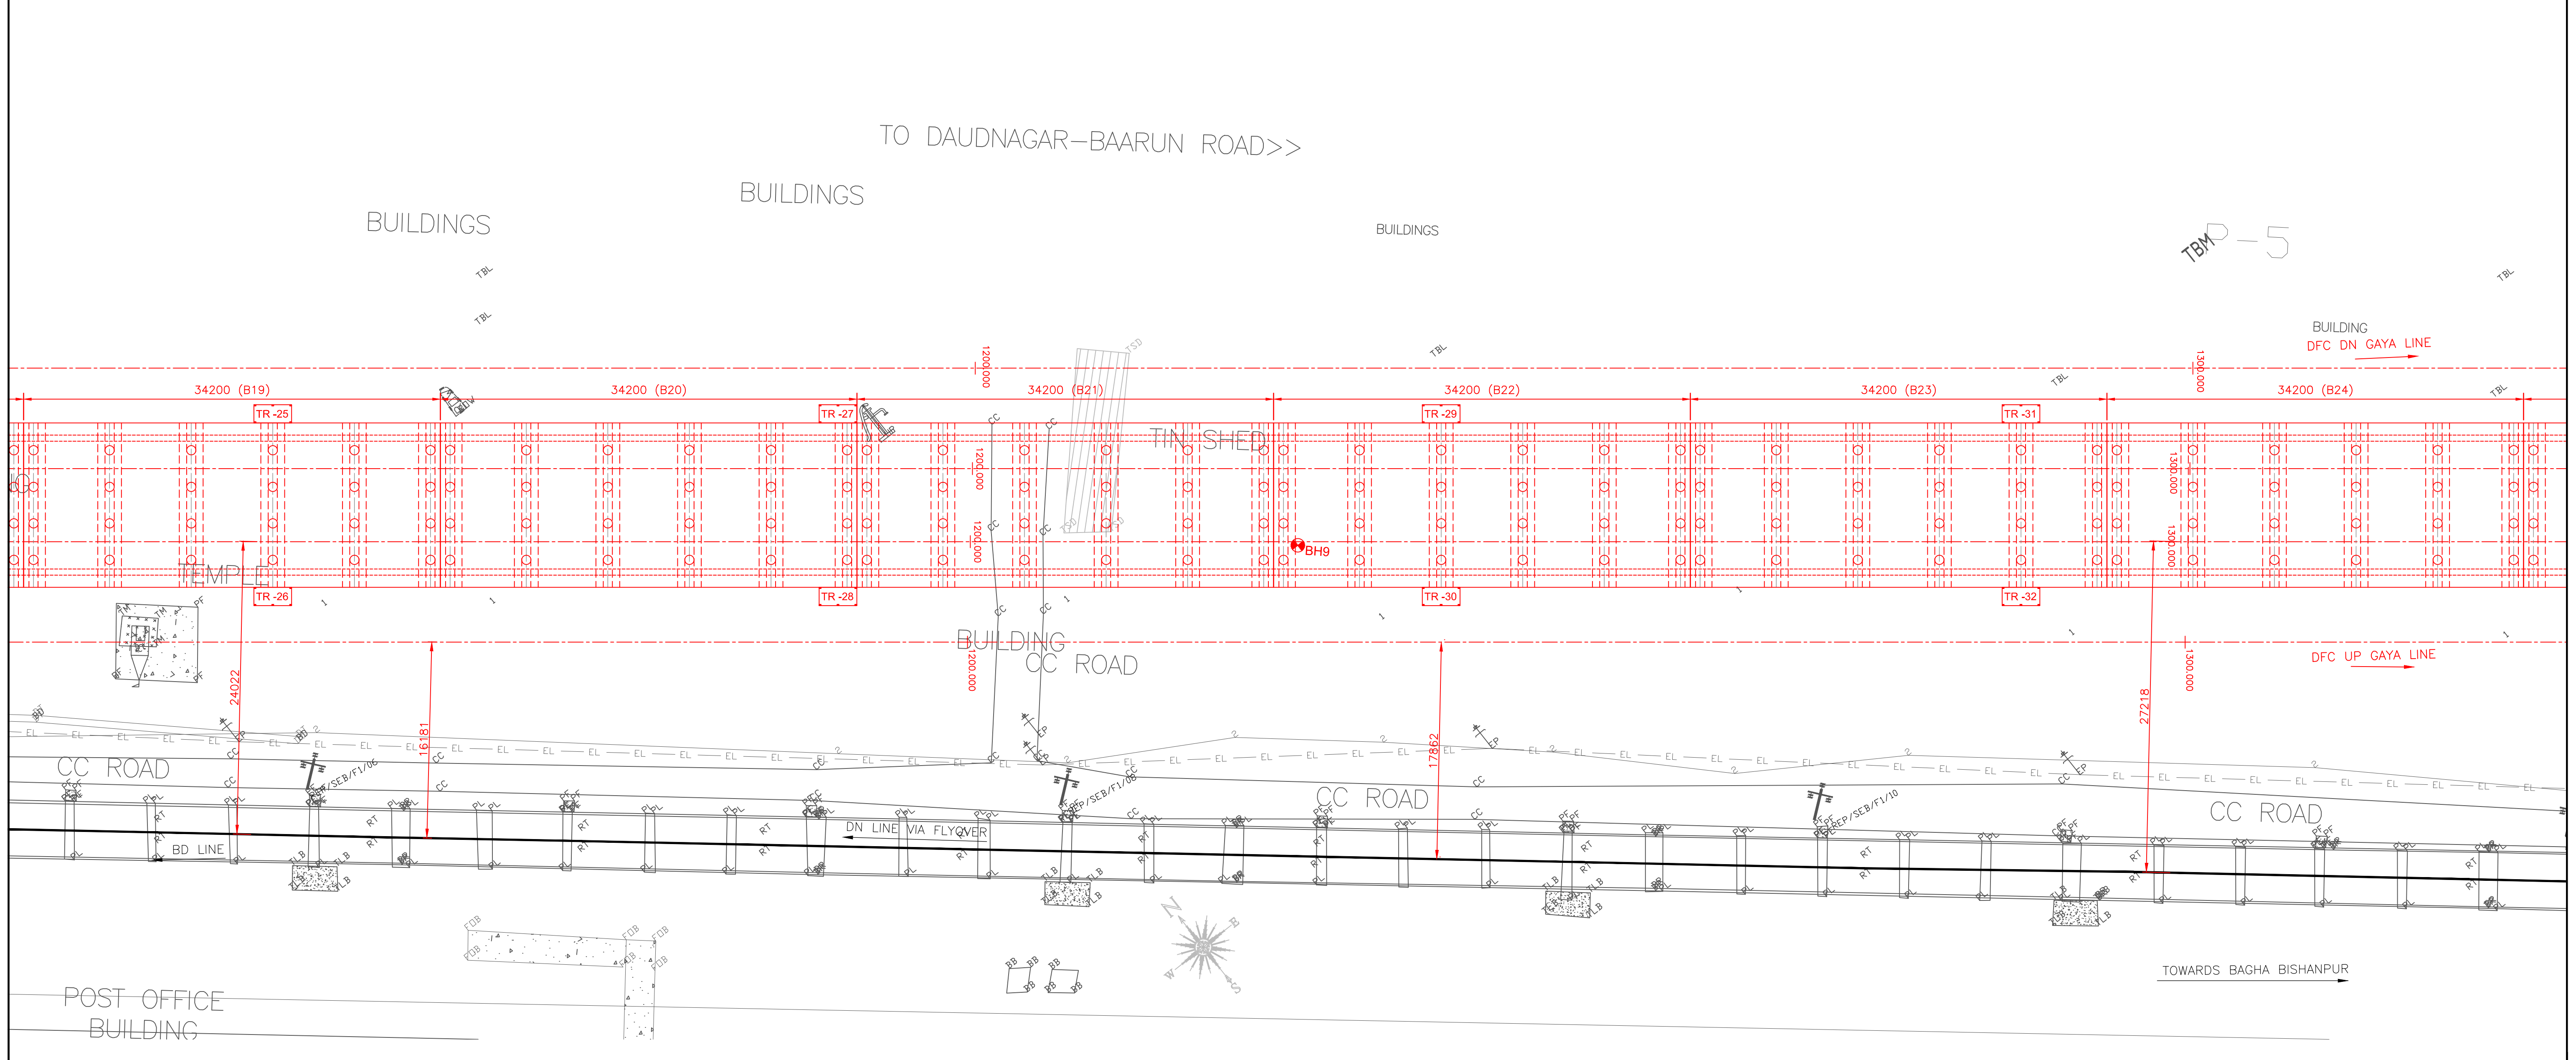

**PLAN**  
(SCALE :- 1:250)

- NOTES:-**
- S & T GEARS IN THE VISINTY OF THE PROPOSED STRUCTURE ARE SHIFTED.
  - THE PROPOSED WORK ARE DONE UNDER THE SUPERVISION OF SSE/SIG/DOO & SSE/T/SEB.

**AS BUILT DRAWING**

DRM/MGS PLAN NO.133-2016 (4/ 11)  
DFCCIL DRG NO:- MGS/EN/ATEPL-MGCP/L/GAD-VIADUCT/184/ 4 (SHEET 4/ 11) / 2016

**LEGEND:**  
TR ——— TROLLEY REFUGE

D							
C							
B							
A							
0	18.01.21	D	AS BUILT DRAWING	KSN	VKS	ASV	ASV
REV. NO.	DATE	STATUS	DESCRIPTION	DESIGNED	DRAWN	CHECK	DESIGN CONS. (PC.)



**DEDICATED FREIGHT CORRIDOR CORPORATION OF INDIA LTD. EASTERN CORRIDOR**

(ASC Infratech Pvt. Ltd.)	CPM	RE	TL
ATEPL-MGCP/L JV		PMC - RODIC CONSULTANTS PVT. LTD.	

**CLIENT:** DEDICATED FREIGHT CORRIDOR CORPORATION OF INDIA LTD.

**CONTRACTOR:** ATEPL - MGCP/L JV

**PROJECT:** Design and Construction of Formation in Embankments/Cuttings including blanketing, Viaducts, Rail Flyover, Bridges (Major, Minor & RUBS), Supply and Spreading of Ballast and other related infrastructural works for double track electrified railway line on Design Build Lump Sum Basis from Howrah end approach of DFC Sone bridge to Chirailapathu station of IR towards Howrah & to New Sonnagar station towards Garhwa and at Dehri-on-Sone yard from Km. 3.16 to Km. 5.38 in connection with Eastern Dedicated Freight Corridor.

**TITLE:** GENERAL ARRANGEMENT DRAWING OF PROPOSED VIADUCT BETWEEN CHAINAGE : 0+520 TO 2+228 (G1)  
प्रस्तावित वायाउवर्ट की सामान्य व्यवस्था द्वारा श्रृंखलानामा: 0+520 से 2+228 (G1) के बीच में

**PROJECT NO.:** P151012

**COP:**

**SCALE:** (SHEET 4 OF 11)

**ASC INFRA TECH PVT LTD.**

**DRAWING NO.:** 1/VD/G1/0001/0