
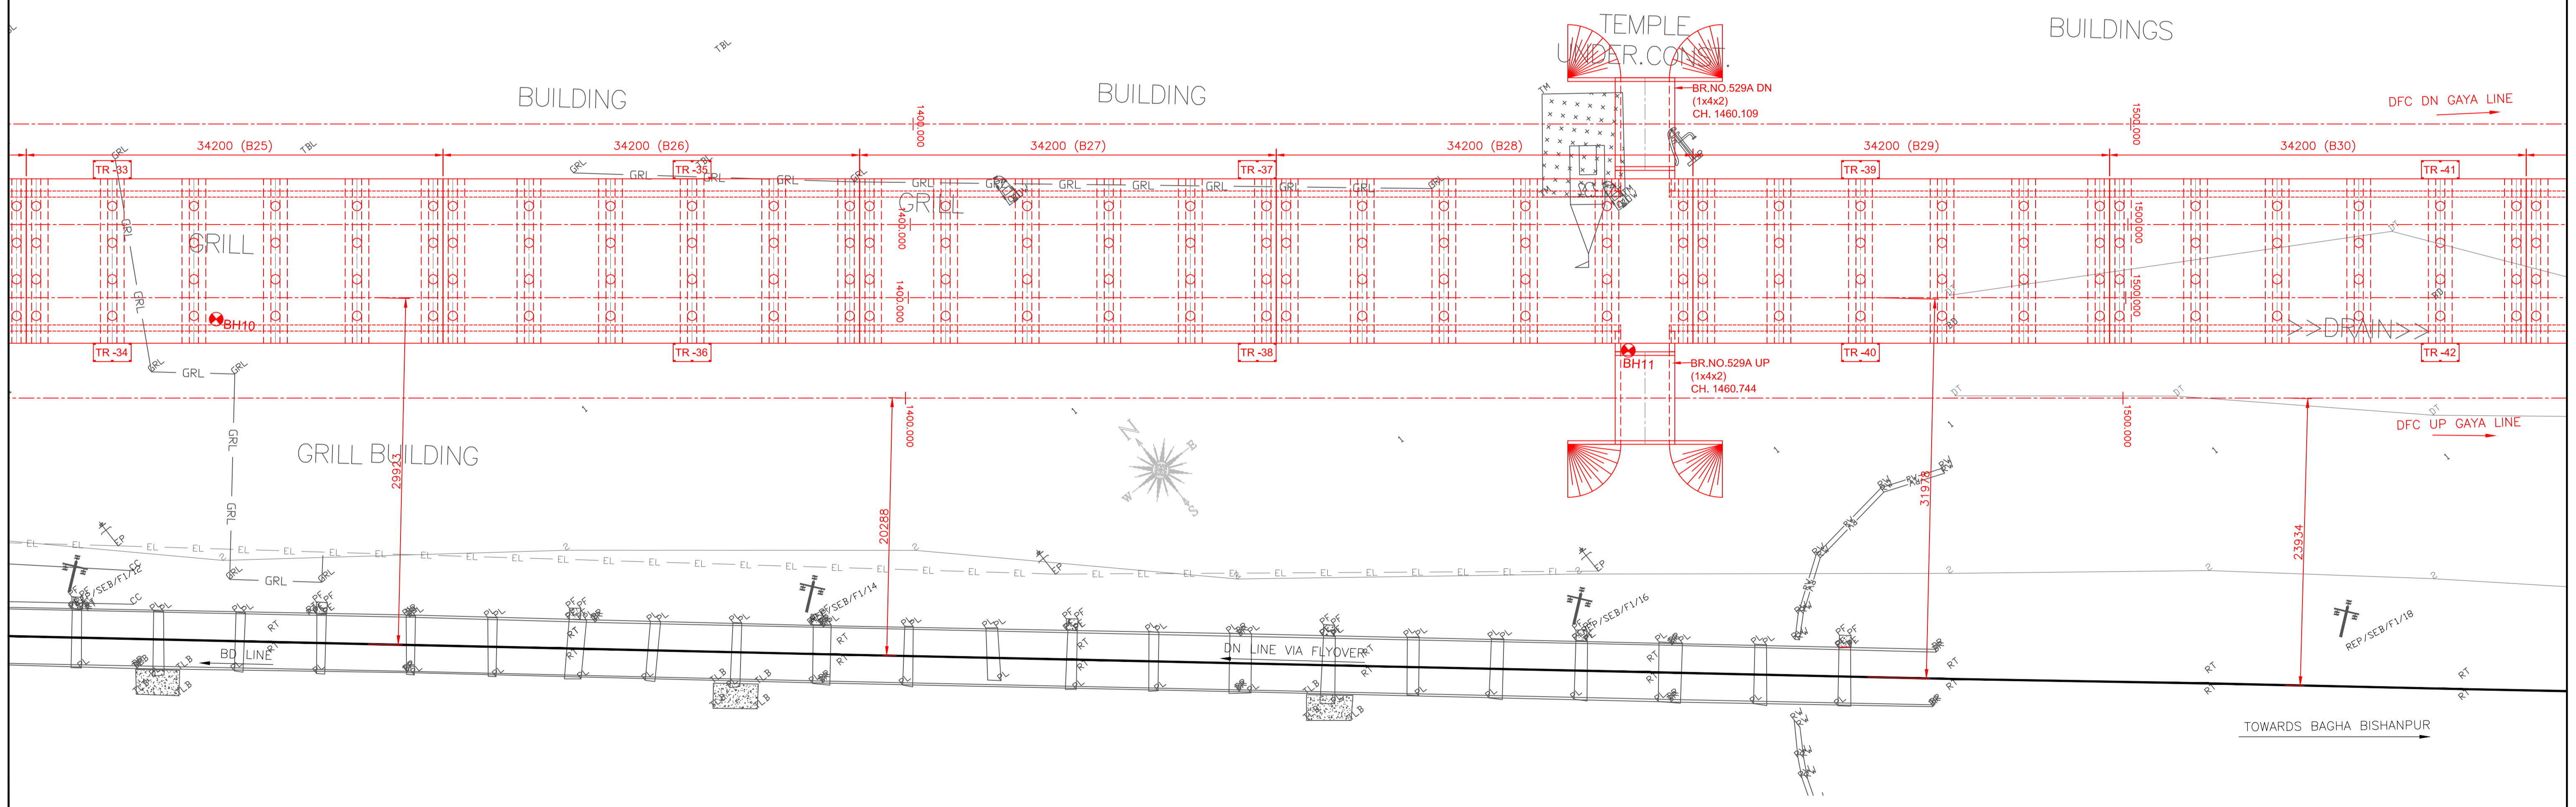


FORMATION LEVEL	112.844	112.922	113.000	113.078	113.156	113.234	113.312	113.390	113.468	113.546
GROUND LEVEL	106.036	105.847	105.803	105.988	106.022	105.619	105.899	105.664	105.552	104.718
CHAINAGE	1340.000	1360.000	1380.000	1400.000	1420.000	1440.000	1460.000	1480.000	1500.000	1520.000

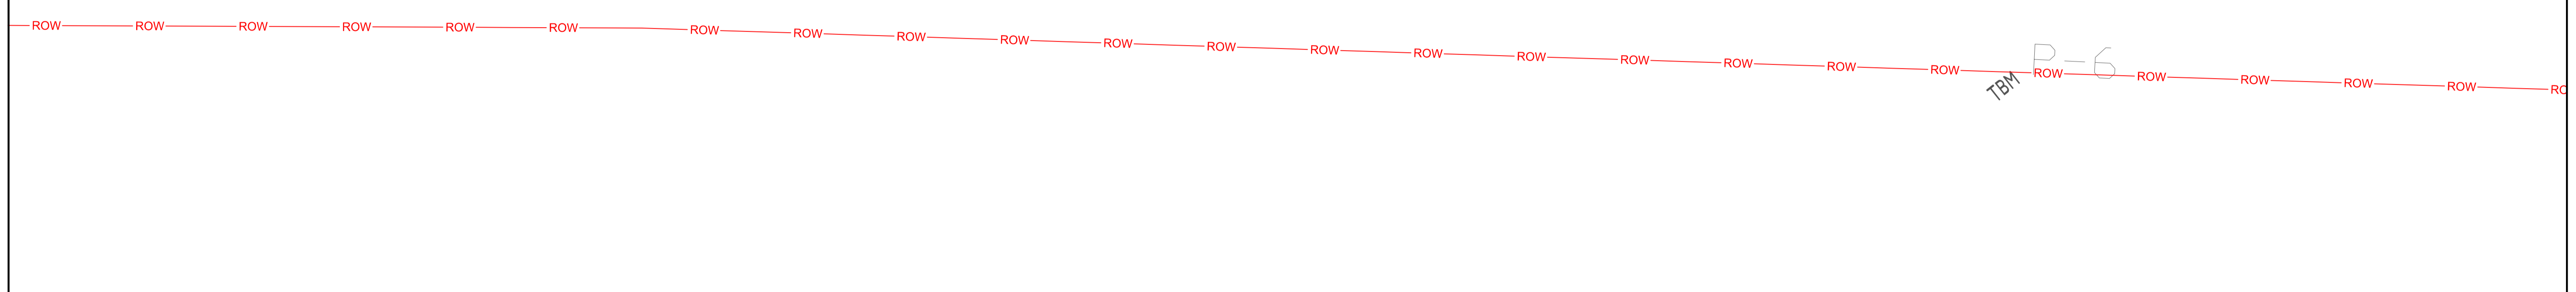

- NOTES:-**
- S & T GEARS IN THE VISINTY OF THE PROPOSED STRUCTURE ARE SHIFTED.
 - THE PROPOSED WORK ARE DONE UNDER THE SUPERVISION OF SSE/SIG/DOO & SSE/T/DEB.

PLAN
(SCALE :- 1:250)

AS BUILT DRAWING

DRM/MGS PLAN NO.133-2016 (5/ 11)
DFCCIL DRG NO:- MGS/EN/ATEPL-MGCPL/GAD-VIADUCT/185/ 5 (SHEET 5/ 11) / 2016

LEGEND:
TR ————— TROLLEY REFUGE

D							
C							
B							
A							
0	18.01.21	D	AS BUILT DRAWING	KSN	VKS	ASV	ASV
REV. NO.	DATE	STATUS	DESCRIPTION	DESIGNED	DRAWN	CHECK	DESIGN CONS. (PC.)



DEDICATED FREIGHT CORRIDOR CORPORATION OF INDIA LTD. EASTERN CORRIDOR

(ASC Infratech Pvt. Ltd.)	CPM	RE	TL
ATEPL-MGCPL JV	PMC - RODIC CONSULTANTS PVT. LTD.		

CLIENT: DEDICATED FREIGHT CORRIDOR CORPORATION OF INDIA LTD.	
CONTRACTOR: ATEPL - MGCPL JV	
PROJECT: Design and Construction of Formation in Embankments/Cuttings including blanketing, Viaducts, Rail Flyover, Bridges (Major, Minor & RUBS), Supply and Spreading of Ballast and other related infrastructural works for double track electrified railway line on Design Build Lump Sum Basis from Howrah end approach of DFC Sone bridge to Chirailapathu station of IR towards Howrah & to New Sonnagar station towards Garhwa and at Dehri-on-Sone yard from Km. 3.16 to Km. 5.38 in connection with Eastern Dedicated Freight Corridor.	PROJECT NO: P151012
TITLE: GENERAL ARRANGEMENT DRAWING OF PROPOSED VIADUCT BETWEEN CHAINAGE : 0+520 TO 2+228 (G1) प्रस्तावित वायाडक्ट की सामान्य व्यवस्था ड्राइंग शृंखलानाम: 0+520 से 2+228 (G1) के बीच में (SHEET 5 OF 11)	COP: SCALE:
ASC INFRA TECH PVT LTD.	DRAWING NO: 1/VD/G1/0001/0