


FORMATION LEVEL	113.624	113.702	113.780	113.858	113.936	114.014	114.092	114.170	114.248	114.326	114.404
GROUND LEVEL	105.268	105.800	105.682	105.531	105.483	105.455	105.649	106.232	105.245	105.249	105.249
CHAINAGE	1540.000	1560.000	1580.000	1600.000	1620.000	1640.000	1660.000	1680.000	1700.000	1720.000	1740.000

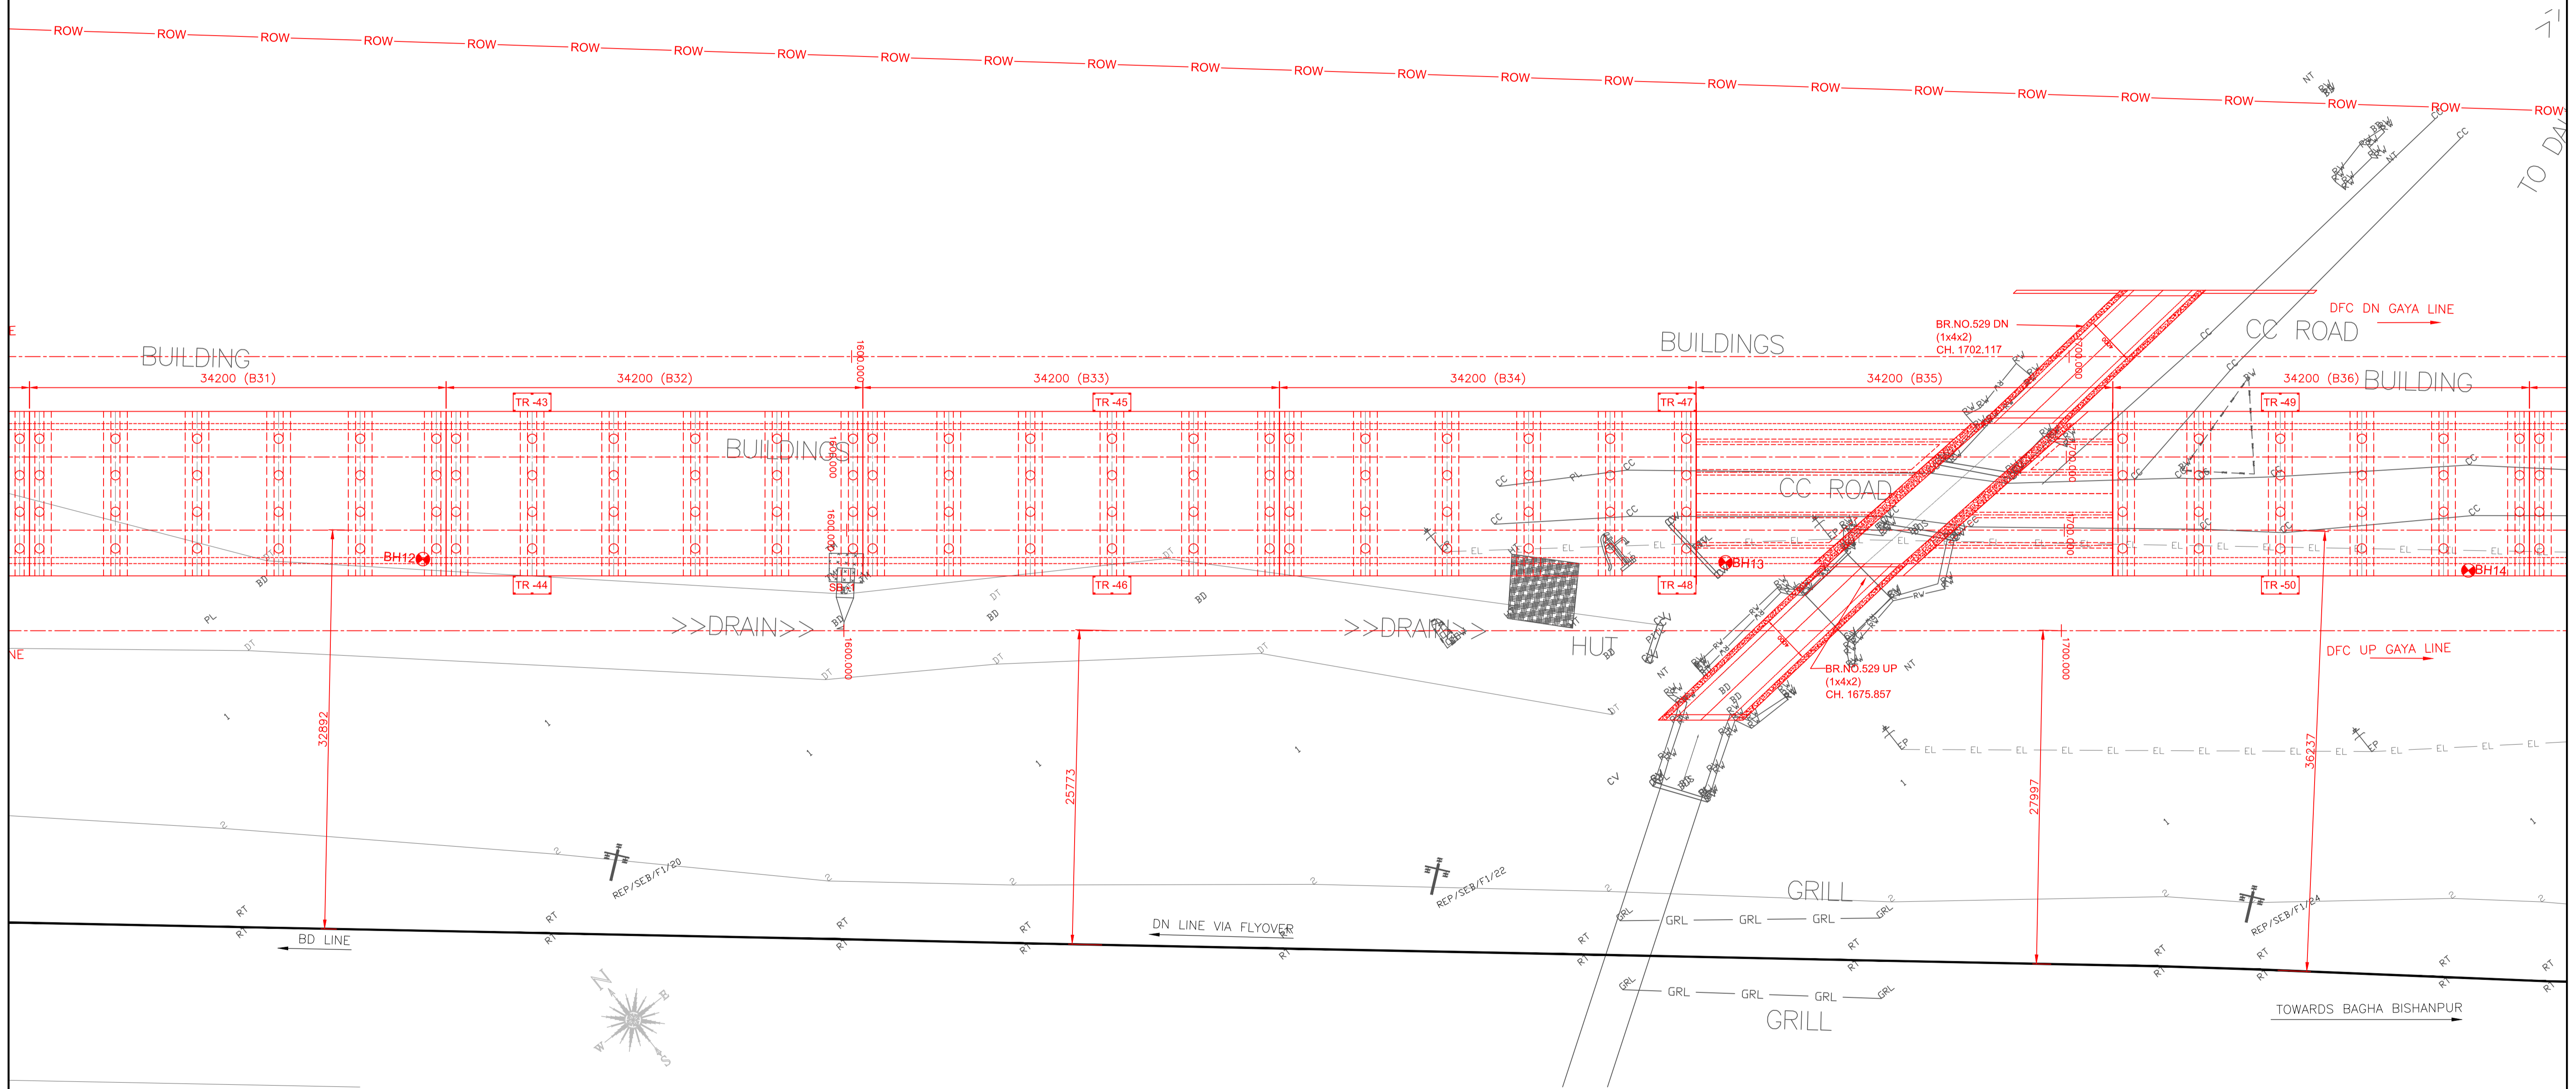

- NOTES:-**
- S & T GEARS IN THE VISINTY OF THE PROPOSED STRUCTURE ARE SHIFTED.
  - THE PROPOSED WORK ARE DONE UNDER THE SUPERVISION OF SSE/SIG/DOS & SSE/T/SEB.

**AS BUILT DRAWING**

**PLAN**  
(SCALE :- 1:250)

DRM/MGS PLAN NO.133-2016 (6/ 11)  
DFCCIL DRG NO:- MGS/EN/ATEPL-MGCP/L/GAD-VIADUCT/186/ 6 (SHEET 6/ 11) / 2016

**LEGEND:**

TR ————— TROLLEY REFUGE

REV. NO.	DATE	STATUS	DESCRIPTION	DESIGNED	DRAWN	CHECK	DESIGN CONS. (PC.)
0	18.01.21	D	AS BUILT DRAWING	KSN	VKS	ASV	ASV



**DEDICATED FREIGHT CORRIDOR CORPORATION OF INDIA LTD. EASTERN CORRIDOR**

(ASC Infratech Pvt. Ltd.)	CPM	RE	TL
ATEPL-MGCP/L JV	PMC - RODIC CONSULTANTS PVT. LTD.		

CLIENT: <b>DFCO</b> DEDICATED FREIGHT CORRIDOR CORPORATION OF INDIA LTD.	PROJECT NO: P151012
CONTRACTOR: <b>ATEPL - MGCP/L JV</b>	COP:
PROJECT: Design and Construction of Formation in Embankments/Cuttings including blanketing, Viaducts, Rail Flyover, Bridges (Major, Minor & RUBS), Supply and Spreading of Ballast and other related infrastructural works for double track electrified railway line on Design Build Lump Sum Basis from Howrah end approach of DFC Sone bridge to Chirailapathu station of IR towards Howrah & to New Sonnagar station towards Garhwa and at Dehri-on-Sone yard from Km. 3.16 to Km. 5.38 in connection with Eastern Dedicated Freight Corridor.	SCALE:
TITLE: GENERAL ARRANGEMENT DRAWING OF PROPOSED VIADUCT BETWEEN CHAINAGE : 0+520 TO 2+228 (G1) प्रस्तावित वायाउक्ट की सामान्य व्यवस्था ड्राइंग श्रृंखलानां: 0+520 से 2+228 (G1) के बीच में	(SHEET 6 OF 11)
<b>ASC INFRA TECH PVT LTD.</b>	DRAWING NO: 1/VD/G1/0001/0