


FORMATION LEVEL	109.923	109.993	110.064	110.134	110.205	110.275	110.345	110.416	110.486	110.557
GROUND LEVEL	103.851	104.760	104.086	104.606	105.646	105.855	106.044	106.437	106.540	106.649
CHAINAGE	520.000	540.000	560.000	580.000	600.000	620.000	640.000	660.000	680.000	700.000

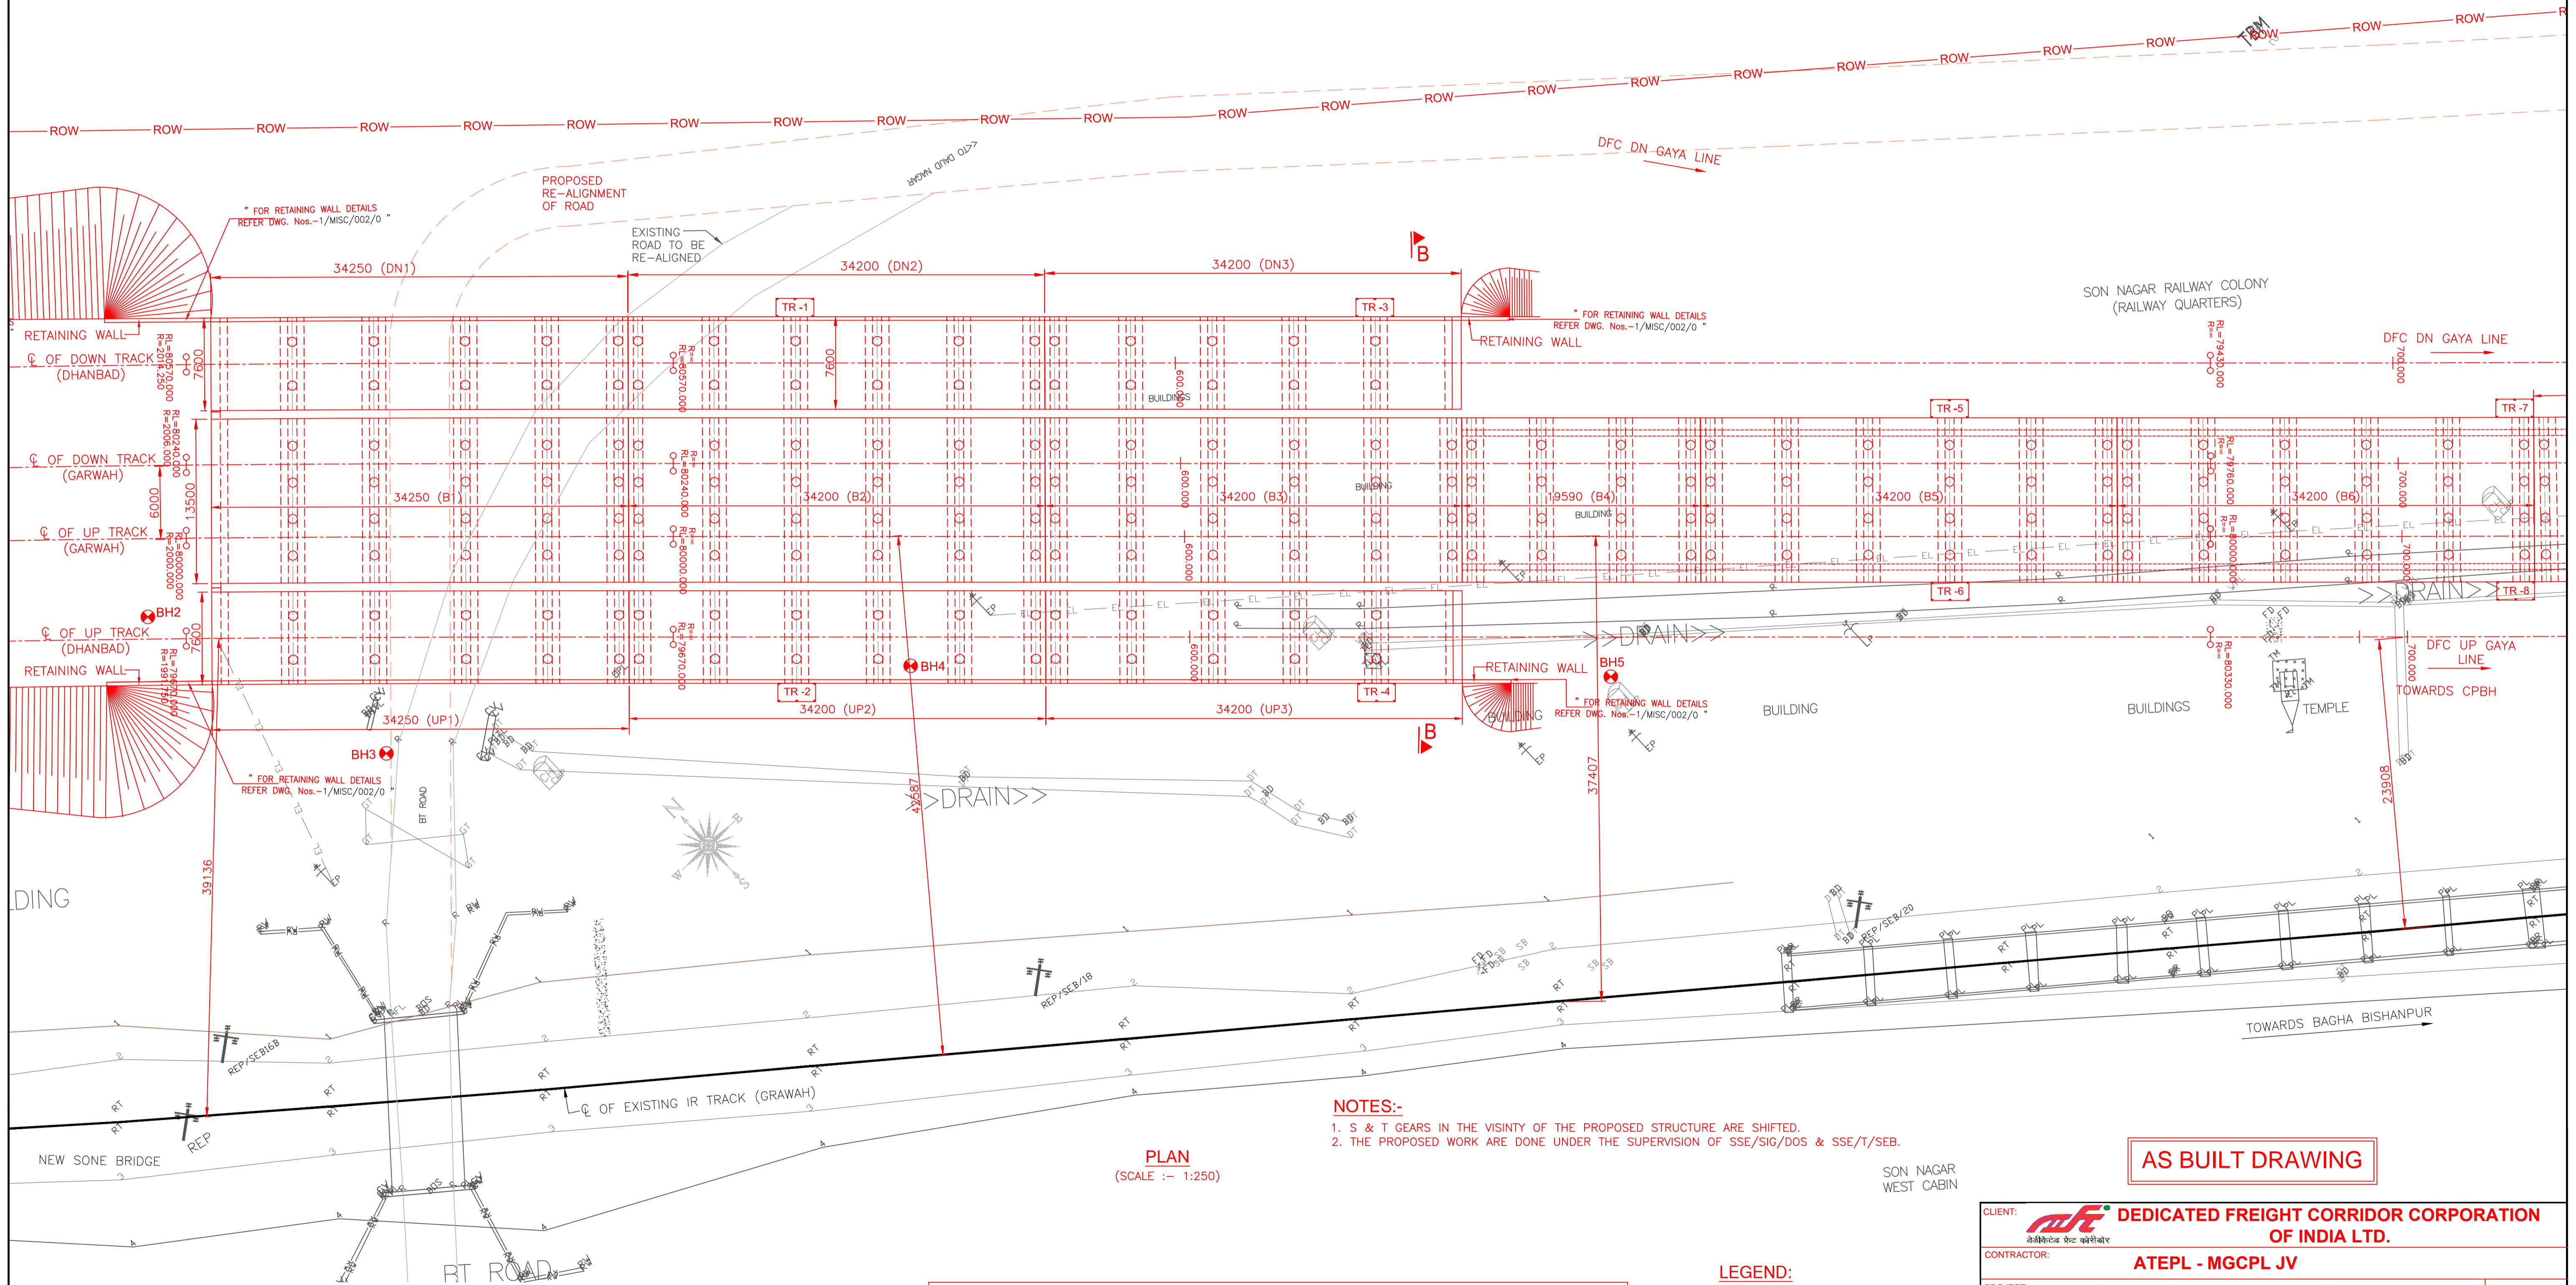

- NOTES:-**
- S & T GEARS IN THE VISINTY OF THE PROPOSED STRUCTURE ARE SHIFTED.
  - THE PROPOSED WORK ARE DONE UNDER THE SUPERVISION OF SSE/SIG/DOS & SSE/T/SEB.

**AS BUILT DRAWING**

DRM/MGS PLAN NO.133-2016 (1/ 11)  
DFCCIL DRG NO:- MGS/EN/ATEPL-MGCPL/GAD-VIADUCT/181/ 1 (SHEET 1/ 11) / 2016

**LEGEND:**  
TR ——— TROLLEY REFUGE

D							
C							
B							
A							
0	18.01.21	D	AS BUILT DRAWING	KSN	VKS	ASV	ASV
REV. NO.	DATE	STATUS	DESCRIPTION	DESIGNED	DRAWN	CHECK	DESIGN CONS. (PC.)



**DEDICATED FREIGHT CORRIDOR CORPORATION OF INDIA LTD. EASTERN CORRIDOR**

(ASC Infratech Pvt. Ltd.)	ATEPL-MGCPL JV	RE	TL
		PMC - RODIC CONSULTANTS PVT. LTD.	

**CLIENT:** DEDICATED FREIGHT CORRIDOR CORPORATION OF INDIA LTD.

**CONTRACTOR:** ATEPL - MGCPL JV

**PROJECT:** Design and Construction of Formation in Embankments/Cuttings including blanketing, Viaducts, Rail Flyover, Bridges (Major, Minor & RUBS), Supply and Spreading of Ballast and other related infrastructural works for double track electrified railway line on Design Build Lump Sum Basis from Howrah end approach of DFC Sone bridge to Chirailapathu station of IR towards Howrah & to New Sonnagar station towards Garhwa and at Dehri-on-Sone yard from Km. 3.16 to Km. 5.38 in connection with Eastern Dedicated Freight Corridor.

**TITLE:** GENERAL ARRANGEMENT DRAWING OF PROPOSED VIADUCT BETWEEN CHAINAGE : 0+520 TO 2+228 (G1)  
प्रस्तावित वायाडक्ट की सामान्य व्यवस्था ड्राइंग श्रृंखला नं. 0+520 से 2+228 (G1) के बीच में (SHEET 1 OF 11)

**PROJECT NO.:** P151012

**COP:**

**SCALE:**

**DRAWING NO.:** 1/VD/G1/0001/0

**ASC INFRA TECH PVT LTD.**