



डेडीकेटेड फ्रेट कोरीडोर

डेडीकेटेड फ्रेट कोरीडोर कार्पोरेशन ऑफ इंडिया लि०
भारत सरकार (रेल मंत्रालय) का उपक्रम
DEDICATED FREIGHT CORRIDOR CORPORATION OF INDIA LIMITED
A Govt. Of India (Ministry of Railways) Enterprise

No. CGM/DFC/UMB/RTI-2024

Date: 22.04.2025


AGM/Admin./PIO
Corporate Office
DFCCIL
New Delhi

Sub: Reply sought under RTI Act 2005.

Ref: (i) RTI registration no. DFCCIL/R/T/25/00016 dated 16.04.2025.

In context to above, please find the attached information received from concerned dept. for your kind information and further necessary action at your end.

DA: As Above.

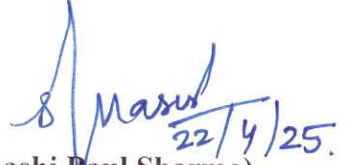
(Shashi Paul Sharma)
Dy. CPM/Elect. & PIO
DFCCIL/Ambala

Mail to: 1. CGM/DFCCIL/Ambala for kind information.
2. PM/Engg./DFCCIL/Ambala for kind information.

NOTE

19.04.2025

Subject :- RTI no. 270 with Registration no. DFCCIL/R/T/25/00016 dated 16.04.2025.

Ref:- RTI application from Sh. Karan sahota R/o House No. 164, Ward No. 12 Brahman Majra, Sirhind, district Fatehgarh sahib Pin - 140406

Reply is given below :-

1.
 - (a) Land plan of village Braham Majra is attached for land boundaries.
 - (b) No Specific information available.
2.
 - (a) Since No debris dumped by DFCCIL, So no contact issued.
 - (b) Not applicable
 - (c) No debris dumped by DFCCIL
3.
 - (a) No
 - (b) Not applicable
 - (c) Not applicable
4.
 - (a) To provide Railway train Services.
 - (b) It is owned by Ministry of Railways and it's a public property. It public Railway line.
 - (c) DFCC track to carry freight only.
 - (d) Brick wall constructed to restrict entry of public to DFCC track for safety of public and trains.
5.
 - (a) Proper access to public has been provided as per requirements.
 - (b) After construction of DFCC track road has been left as per site requirements.
 - (c) No such provision available.
6.
 - (a) Yes, some minor work in progress.
 - (b) DLP:- May 2026.
 - (c) Proper Pathways like RUB & ROB has been constructed.

PM/Engg./UMB

Dy.PM/Engg./CHAN

Handwritten signature
21/04/2025

Handwritten signature
22/04/25


Handwritten signature
22/04/25

Handwritten signature
21/4/25
Handwritten signature

Handwritten text: PIO/UMB - may please see & approve the reply of me
22/4/25

INDIAN RAILWAY
AMBALA DIVISION, NORTHERN RAILWAY
AUTHENTICATED LAND PLAN OF VILL. BRAHMAN MAJRA
TEH. & DISTT. FATEHGARH SAHIB, PUNJAB

N.R. DIVL. PLAN NO. 269
NOTES :-
1. EXISTING WORK SHOWN IN BLACK
2. PROPOSED WORK SHOWN IN RED
SCALE : 1" = 387'

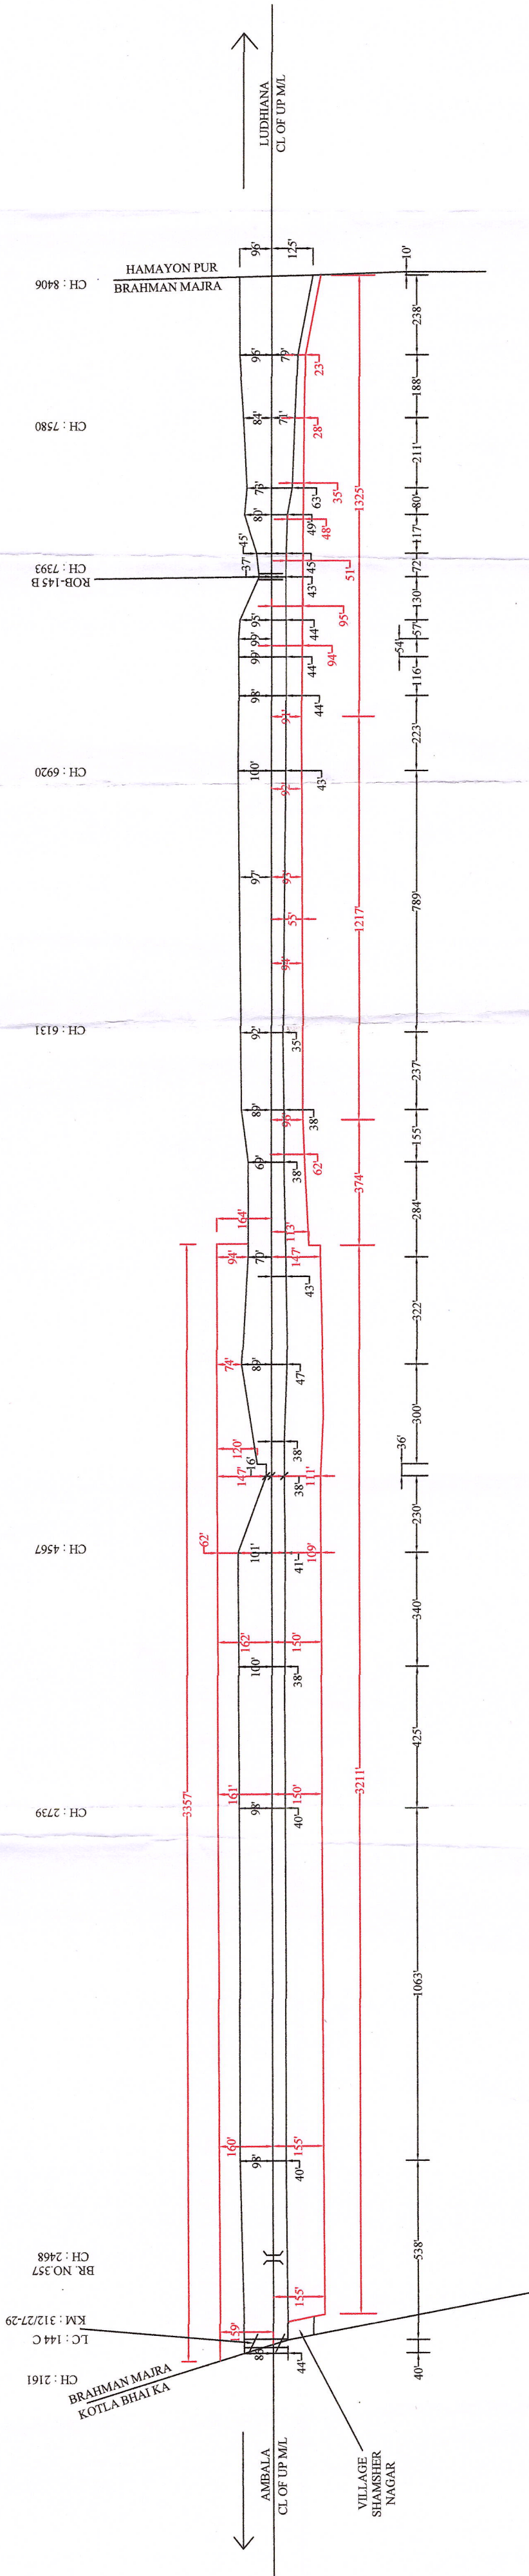

DETAIL OF AREA ACQUIRED IN 2011									
S.NO.	VILLAGE	KHASRA NO.	AREA ACQUIRED			9/1	0	17	1
			KANAL	MARLA	SQ. KARAM				
1	BRAHMAN MAJRA	4/2	0	15	0	2	1	16	5
2		24	3	3	5	21	2	14	1
3		18	3	14	6	25	2	15	0
4		19	3	3	7	17	1	16	4
5		12	0	14	0	18	0	6	2
6		11/1	0	16	0	13/2	0	4	0
7		11/2	2	16	0	12	2	4	0
8		10/3	0	1	0	9	0	11	0
9		6	3	13	1	387	1	4	6
10		7	2	2	7	TOTAL	60	5	0
11		4/2	0	2	7				
12		4/1	1	6	8				
13		3	2	17	3				
14		23	0	10	6				
15		22	3	11	7				
16		19	0	0	2				
17		21/2	1	4	5				
18		20	2	2	6				
19		39	2	12	2				
20		16	1	15	5				
21		15	0	15	6				
22		14	1	18	4				
23		7/2	0	1	3				
24		8	2	18	1				

DETAIL OF AREA ACQUIRED IN 2014					
S.NO.	VILLAGE	MUSTEEL NO.	KHASRA NO.	AREA ACQUIRED	
				KANAL	SQ. KARAM
1	BRAHMAN MAJRA	36	24/1	1	3
2			18	2	19
3			19	0	9
4			12	1	1
5			11/2	1	3
6			10/1	0	0
7			10/2	0	2
8			10/3	0	7
9			6	1	13
10			3	0	16
11		37	5	0	0
12			4/2	0	18
13			4/1	1	1
14			39	0	3
15			23	0	19
16			16	2	0
17			19	0	4
18			20	2	1
19			15	1	3
20			14	1	2
21		33	7/2	0	7
22			8	0	9
23					
24					

23			7	1	0	2
24			4/1	1	19	3
25			3	1	10	4
26			2	0	1	3
27			22	2	15	3
28			93 RASTA	2	12	7
29			73 KHAAL	0	3	7
30			20	2	11	6
31			16	2	9	7
32			15	1	2	0
33			14	3	10	7
34			13	0	5	7
35			8	3	8	8
36			9/1	0	5	0
37			9/2	1	1	3
38			2	2	6	2
39			1	2	15	8
40			21/1	0	16	0
41			25	5	0	0
42			24	0	17	0
43			17	3	12	0
44			18	2	11	5
45			13	2	3	0
46			12	2	5	7
47			9/1	1	4	0
48			11	0	1	1
49			10	1	0	0
TOTAL				69	10	2

REVENUE MEASUREMENT
Khasra No. = 3025 SQ. FT. = 2664 M.
1 SQ. KARAM = 3025 SQ. FT. = 2803 SQ. M.
1 MARLA = 9 SQ. KARAM = 25297 SQ. M.
1 KANAL = 20 MARLA = 5445 SQ. FT. = 505.854 SQ. M.
1 ACRE = 8 KANAL = 4840 SQ. YDS. = 43560 SQ. FT. = 4046.832 SQ. M.

AREA OF GOVERNMENT LAND				
S.NO.	KHASRA NO.	AREA ACQUIRED		
		KANAL	MARLA	SQ. KARAM
1	75	0	14	6
2	45/4/22	0	11	0
3	36/24/2	0	13	0
4	80	3	14	3
TOTAL		5	13	0

DETAIL OF AREA ACQUIRED IN 2017						
S.NO.	VILLAGE	MUSTEEL NO.	KHASRA NO.	AREA ACQUIRED		
				KANAL	MARLA	SQ.KARAM
1	BRAHMAN MAJRA	36	21	0	12	7
TOTAL				0	12	7

EXISTING RAILWAY AREA							
S.NO.	VILLAGE	AREA ACQUIRED					
		BIGHA	BISWA	BISWANSI	KANAL	MARLA	SQ.KARAM
1	BRAHMAN MAJRA	90	7	0	150	12	3
TOTAL		90	7	0	150	12	3

AREA ACQUIRED				
DESCRIPTION	KANAL	MARLA	SQ. KARAM	
EXISTING RAILWAY AREA	150	12	3	
AREA ACQUIRED IN 2011	60	5	0	
AREA ACQUIRED IN 2014	9	10	2	
AREA ACQUIRED IN 2017	0	12	7	
AREA OF GOVT. LAND	5	13	0	
TOTAL AREA OF RAILWAY	286	13	3	

REVENUE OFFICE FATEHGARH SAHIB		DFCCIL	
DISTT REVENUE OFFICER		PM / ENGG / UMB (HARSIMRAN SINGH)	
TEHSILDAR		DPM / ENGG / UMB (AMAR NATH)	
KANCOONGO		J-EXP / ENGG / UMB (SUMIT KUMAR)	
PATWARI			