NEW UNCHDIH CROSSING STATION

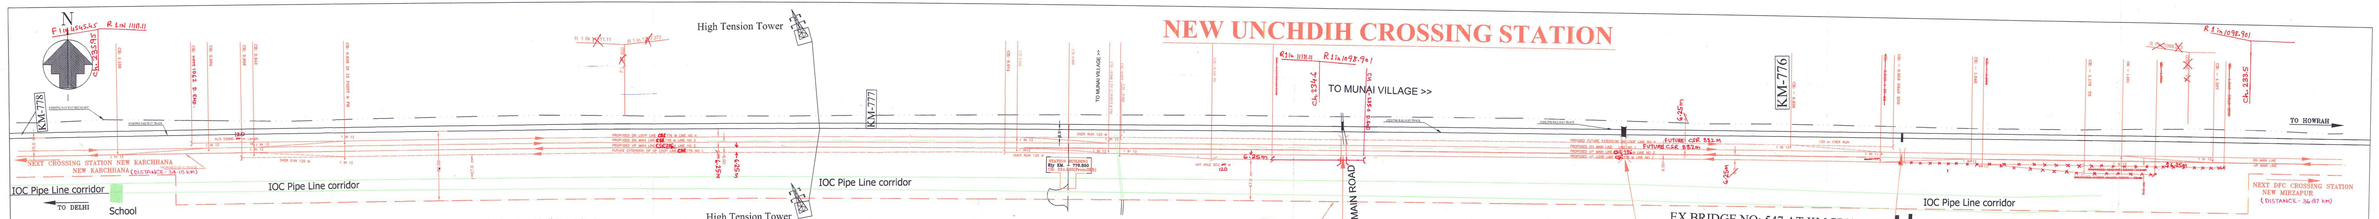

NOTE
" FOR BRIDGE DETAILS, RESPECTIVE PROJECT SHEET SHOULD BE FOLLOWED".

NOTES:
A: EXISTING WORK SHOWN IN BLACK.
B: PROPOSED WORK SHOWN IN RED.
C: PROPOSED RAILWAY (DFCC) BOUNDARY SHOWN IN RED DOTTED.
D: Rly Kms SHOWN ARE REFCKONED FROM HOWRAH STATION.
E: F.L. BETWEEN OUTER MOST FACING POINT IN THE YARD SHALL BE MEASURED ALONG THE CENTRE OF THE TRIBN OF THE POINTS.
F: CALCULEAR AVAILABLE LENGTH FROM POINT TO POINT
G: TTE TURNOUTS WILL HAVE PSC SLEEPERS & CENTUP SWITCHES WITH CMS CROSSING.
H: PROPOSED DFC GRADES ARE IN RED.
I: RDP IS PREPARED ONLY FOR DFC ROUTE & NOT IR YARD DRAWING.
J: THE ROAD HAS IMPACTED & FOUND FEASIBLE TO EXECUTE THE WORK.
K: THERE IS NO INTERDEPENDENT TO SCHEDULE OF WORK.

LEGEND:
EXISTING LINE SHOWN AS
PROPOSED LINE SHOWN AS
PROPOSED FUTURE LINE/LOOPS SHOWN AS
PROPOSED LAND BOUNDARY SHOWN AS
DEMANDED/LIQ WORK SHOWN AS

DFCC
DEDICATED FREIGHT CORRIDOR

PROJECT OFFICE/ALD(E)		CORPORATE OFFICE	
CPM		DIRECTOR (PP)	
PM/T		DIRECTOR (OP&BD)	
APM/T		GM/CO/EC	
AP.M/ENGG		GM/S&T/EC	
APM/ELEC.		GM/(OP)	
APM/Con./S&T		GM/ELECT/EC	
Sr. EXE./ENGG		AGM/ELEC	
		AM/Traffic	
		CONSULTANT:S&T	

AM/ENGG/EC
AM/ELEC/EC

Dedicated Freight Corridor corporation of India limited
Eastern Corridor

Office of CPM/Allahabad (East)

PROJECT	YARD PLAN FOR CROSSING STATION AT NEW UNCHDIH
DETAIL	
SCALE	1:2000
DRG.NO.	Drg. No. DFC/ALD/E/20132 — Date :- 22.11.11